

- LEGEND:**
- 882 — — PROPOSED MINOR CONTOUR.
 - 880 — — PROPOSED MAJOR CONTOUR.
 - M.F.E.E. — MINIMUM FRONT EXPOSURE ELEVATION.
 - M.R.E.E. — MINIMUM REAR EXPOSURE ELEVATION.
 - x 800.00 — AS-BUILT SPOT ELEVATION.


THE VINEYARDS AT CAMBRIDGE

AS-BUILT LOT LINE GRADING PLAN

PAGE: 1 OF 2



DATED: NOVEMBER 18, 2016

QUAM ENGINEERING, LLC
Residential and Commercial Site Design Consultants

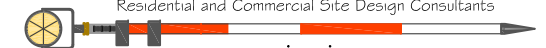

www.quamengineering.com

4604 Siggelkow Road, Suite A, McFarland, Wisconsin 53558
Phone (608) 838-7750; Fax (608) 838-7752

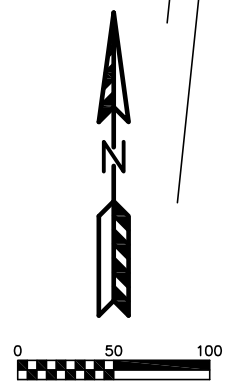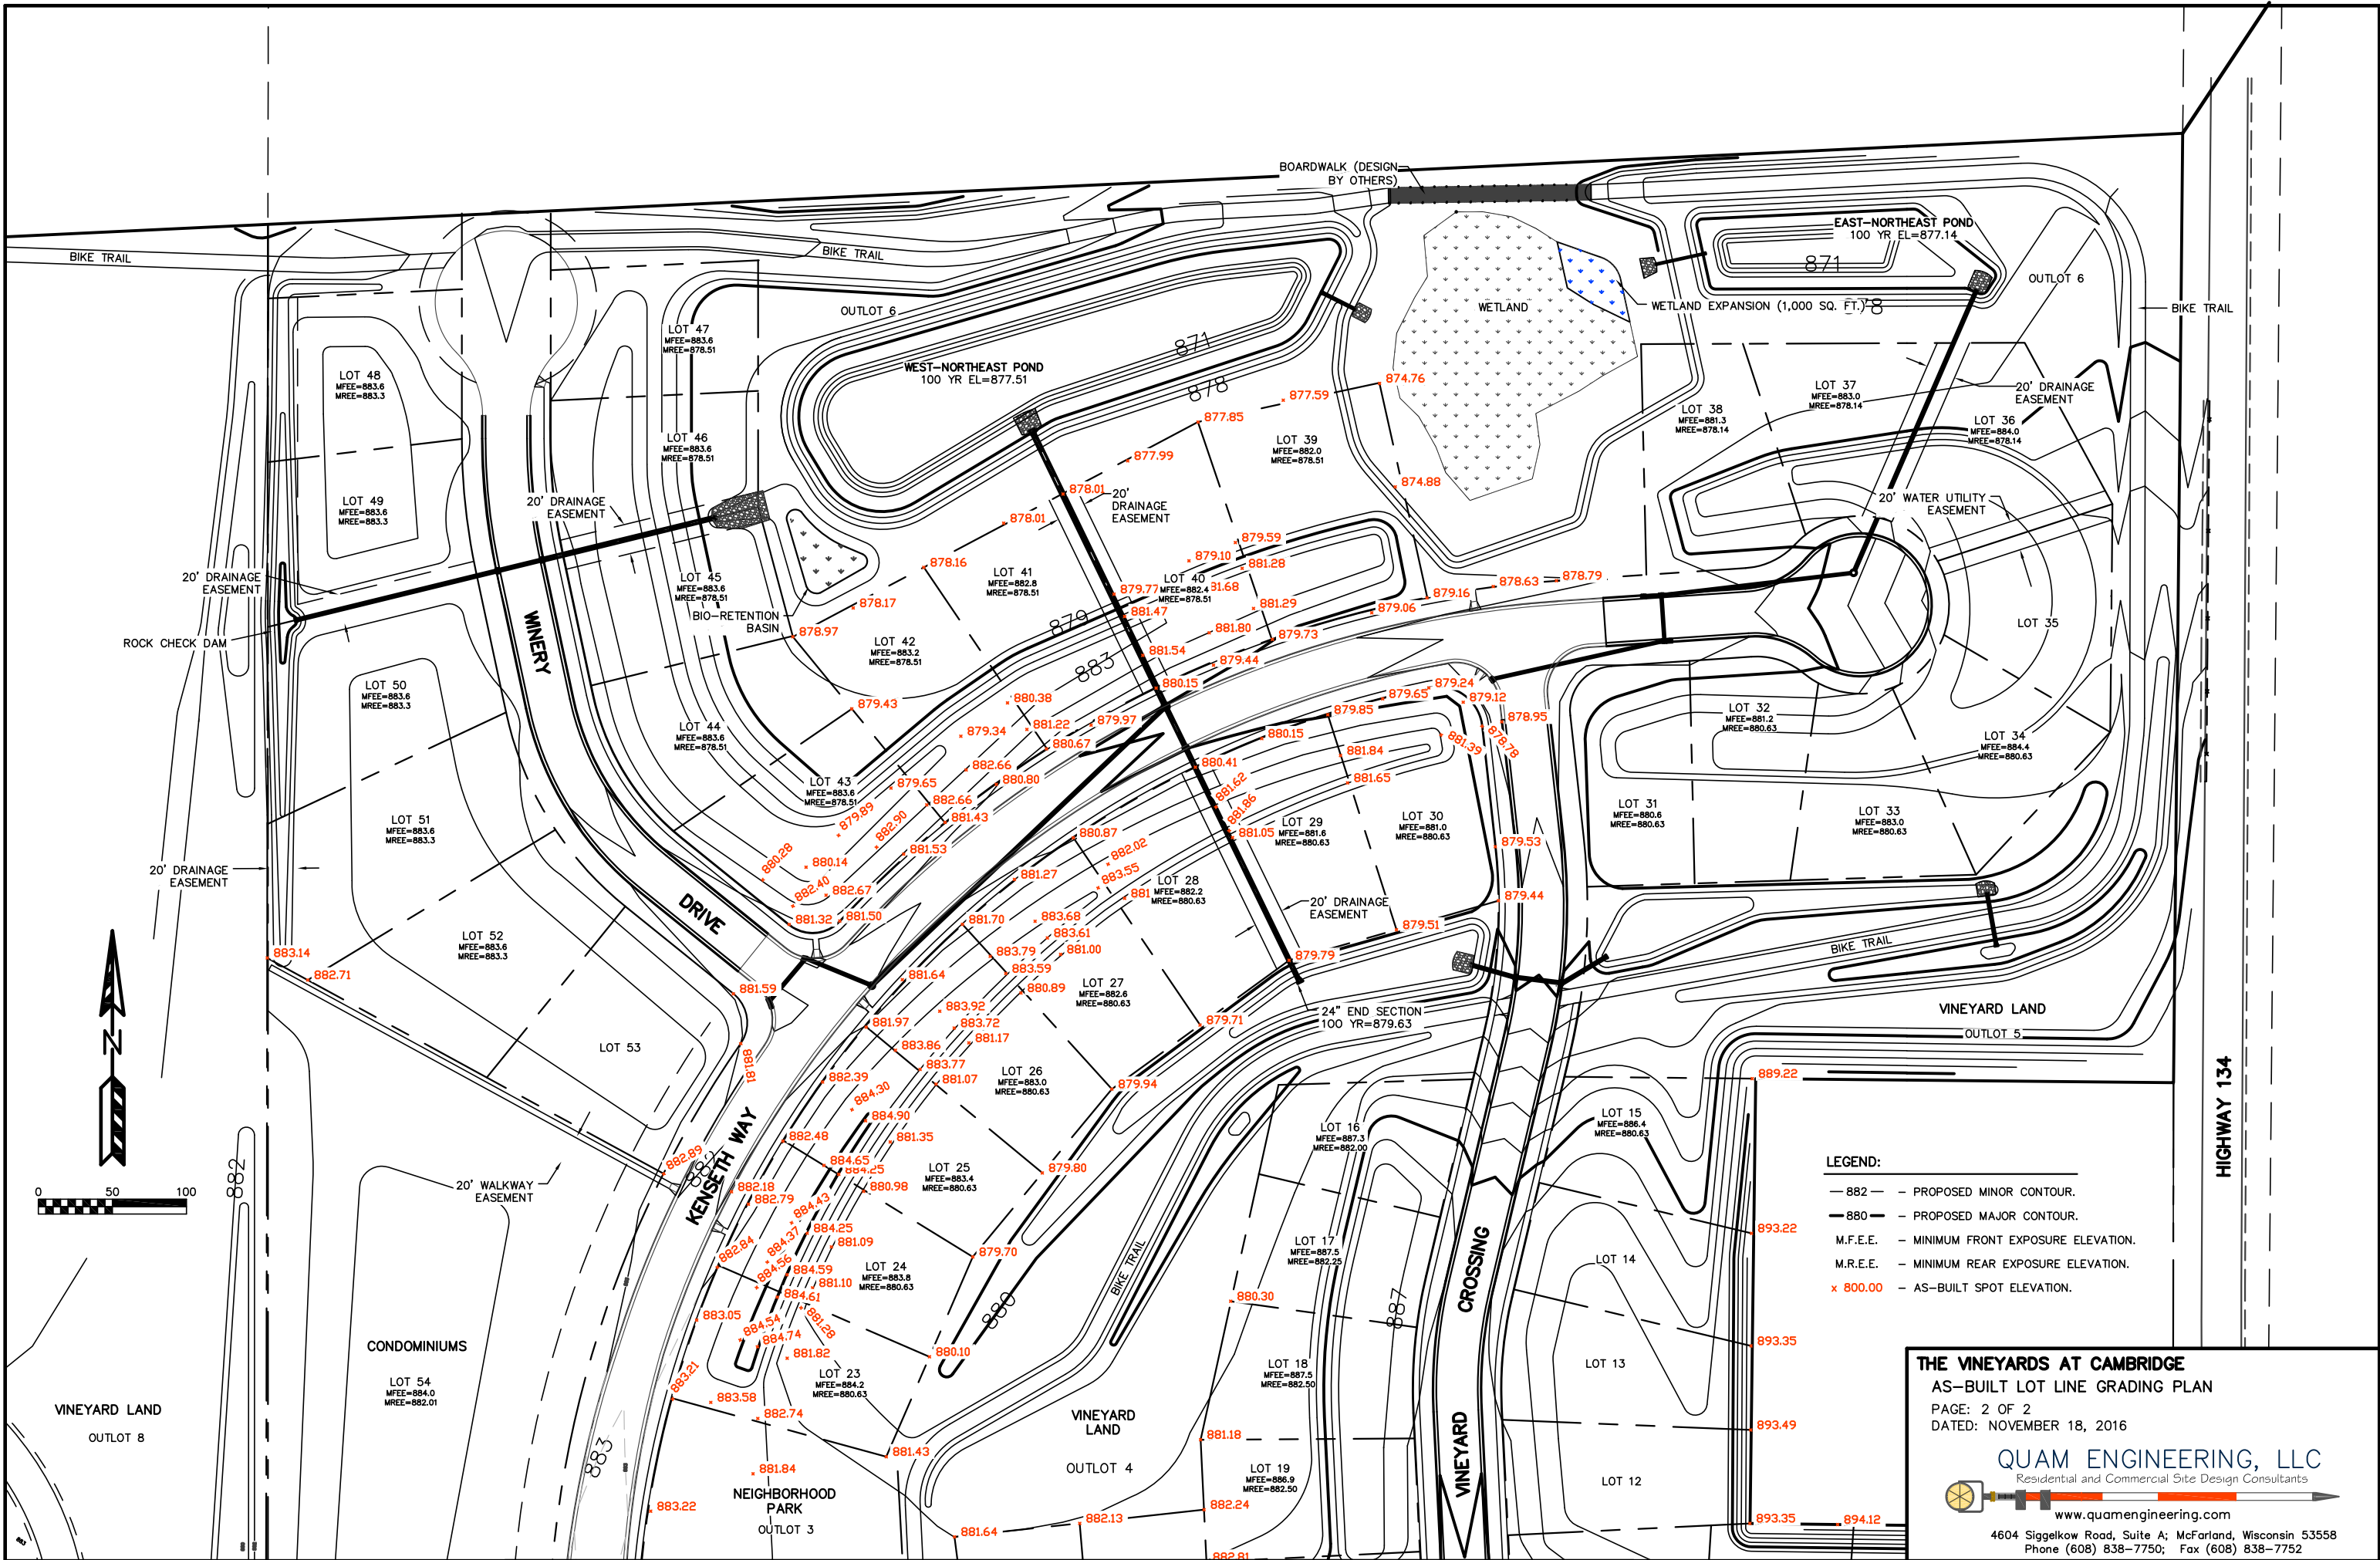

- LEGEND:**
- 882 — — PROPOSED MINOR CONTOUR.
 - 880 — — PROPOSED MAJOR CONTOUR.
 - M.F.E.E. — MINIMUM FRONT EXPOSURE ELEVATION.
 - M.R.E.E. — MINIMUM REAR EXPOSURE ELEVATION.
 - x 800.00 — AS-BUILT SPOT ELEVATION.

THE VINEYARDS AT CAMBRIDGE
 AS-BUILT LOT LINE GRADING PLAN
 PAGE: 2 OF 2
 DATED: NOVEMBER 18, 2016

QUAM ENGINEERING, LLC
 Residential and Commercial Site Design Consultants
 www.quamengineering.com
 4604 Siggelkow Road, Suite A; McFarland, Wisconsin 53558
 Phone (608) 838-7750; Fax (608) 838-7752